


[illegible]

Site Plan Review
Revised Plans - Revision #2
Received: 7/23/2026
City of Kalamazoo
E.Szymanski

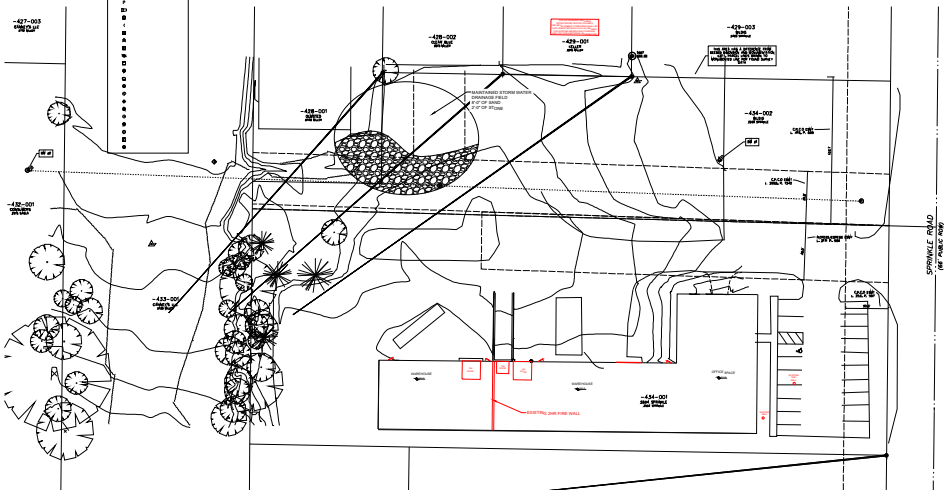

DATE	PLAN SUBMITTALS AND REVISIONS
08/08/2024	W/04 WATER REVIEW

Prein & Newhof

PRECISION GLASS

BUILDING ADDITION AND SITE IMPROVEMENTS
EXISTING CONDITIONS

2260266
C100


C100

REVISIONS

DATE	DESCRIPTION
01/11/11	ISSUED FOR PERMIT
02/11/11	ISSUED FOR PERMIT
03/11/11	ISSUED FOR PERMIT



SCALE: 1" = 20' OF FIELD 24" X 36" 1/4" = 1' 1/4"

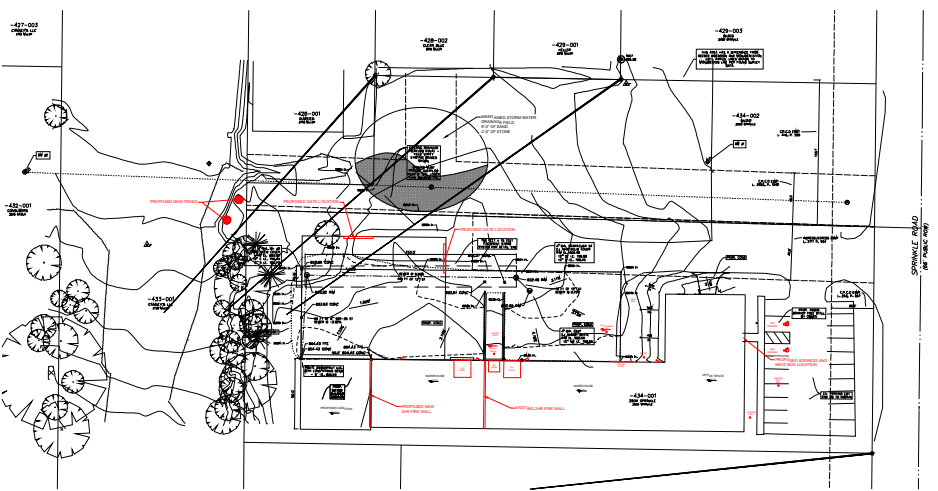

REV	DESCRIPTION	DATE
1	ISSUED FOR PERMIT	01/11/11
2	ISSUED FOR PERMIT	02/11/11
3	ISSUED FOR PERMIT	03/11/11

Prein & Newhof

ENGINEERS

PRECISION GLASS

BUILDING ADDITION AND SITE IMPROVEMENTS

PROPOSED STORMWATER SYSTEM

PROJECT NO. 2260266

SHEET NO. C200


Saving CC

TREES 2 ADDITIONAL TO BE PROVIDED -
 2 EXISTING BURNED AT FRONT AND N. SIDE
 (S) TREES EXISTING AT WEST SIDE OF NEW BUILDING

EXISTING BUILDING:
USE GROUP B & S1
CONSTRUCTION TYPE - SB (UNPROTECTED)
NO INSIDE VEHICLE STORAGE

BUILDING AREA: 30798.9 SQ FT TOTAL
 EXISTING: 18850.0 SQ FT
 PROJECT: SALES / OFFICE H-4444
 2 HOUR FIRE SEPARATION
 MIDDLE AREA STORAGE - METAL 5384.0 SQ FT
 2 HOUR FIRE SEPARATION
 NEW PROPOSED AREA:
 PROPOSED: 48'-0" X 50'-0" = 2,400 SQ FT
 BUILDING HT: 14' 0" / 24' RIDGE
 GOLD STORAGE - METAL

NO DEWATERING, GENERATORS, GUMP PUMPS OR SNOW MELT SYSTEMS PROPOSED

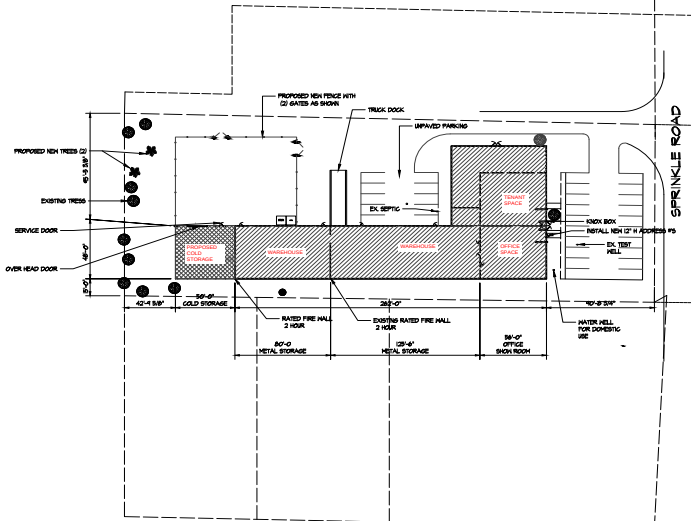

DATE	PLUG SUBSTITUTION AND REVISIONS
01/08/2004	ENHANCED REVC

Prein & Newhof

PRECISION GLASS
CORPORATION
BUILDING ADDITION AND SITE IMPROVEMENTS

PROJECT NO.
2260266
SHEET NO.
C201

